

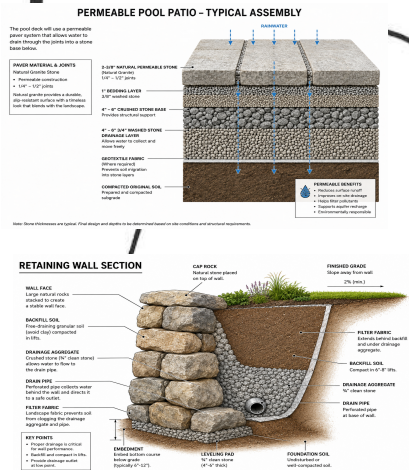


MITIGATION CALCULATIONS		
0-50'	50-100'	TOTAL
IMPERVIOUS = 0 SQ FT MITIGATION = 0 SQ FT (2:1)	IMPERVIOUS = 294.7 SQ FT MITIGATION = 294.7 SQ FT	
PERVIOUS = 270.8 SQ FT MITIGATION = 270.8 SQ FT (1:1)	PERVIOUS = 384.1 MITIGATION = NOT REQUIRED	=565.5 SQ FT
TOTAL = 270.8 SQ FT	TOTAL = 294.7 SQ FT	

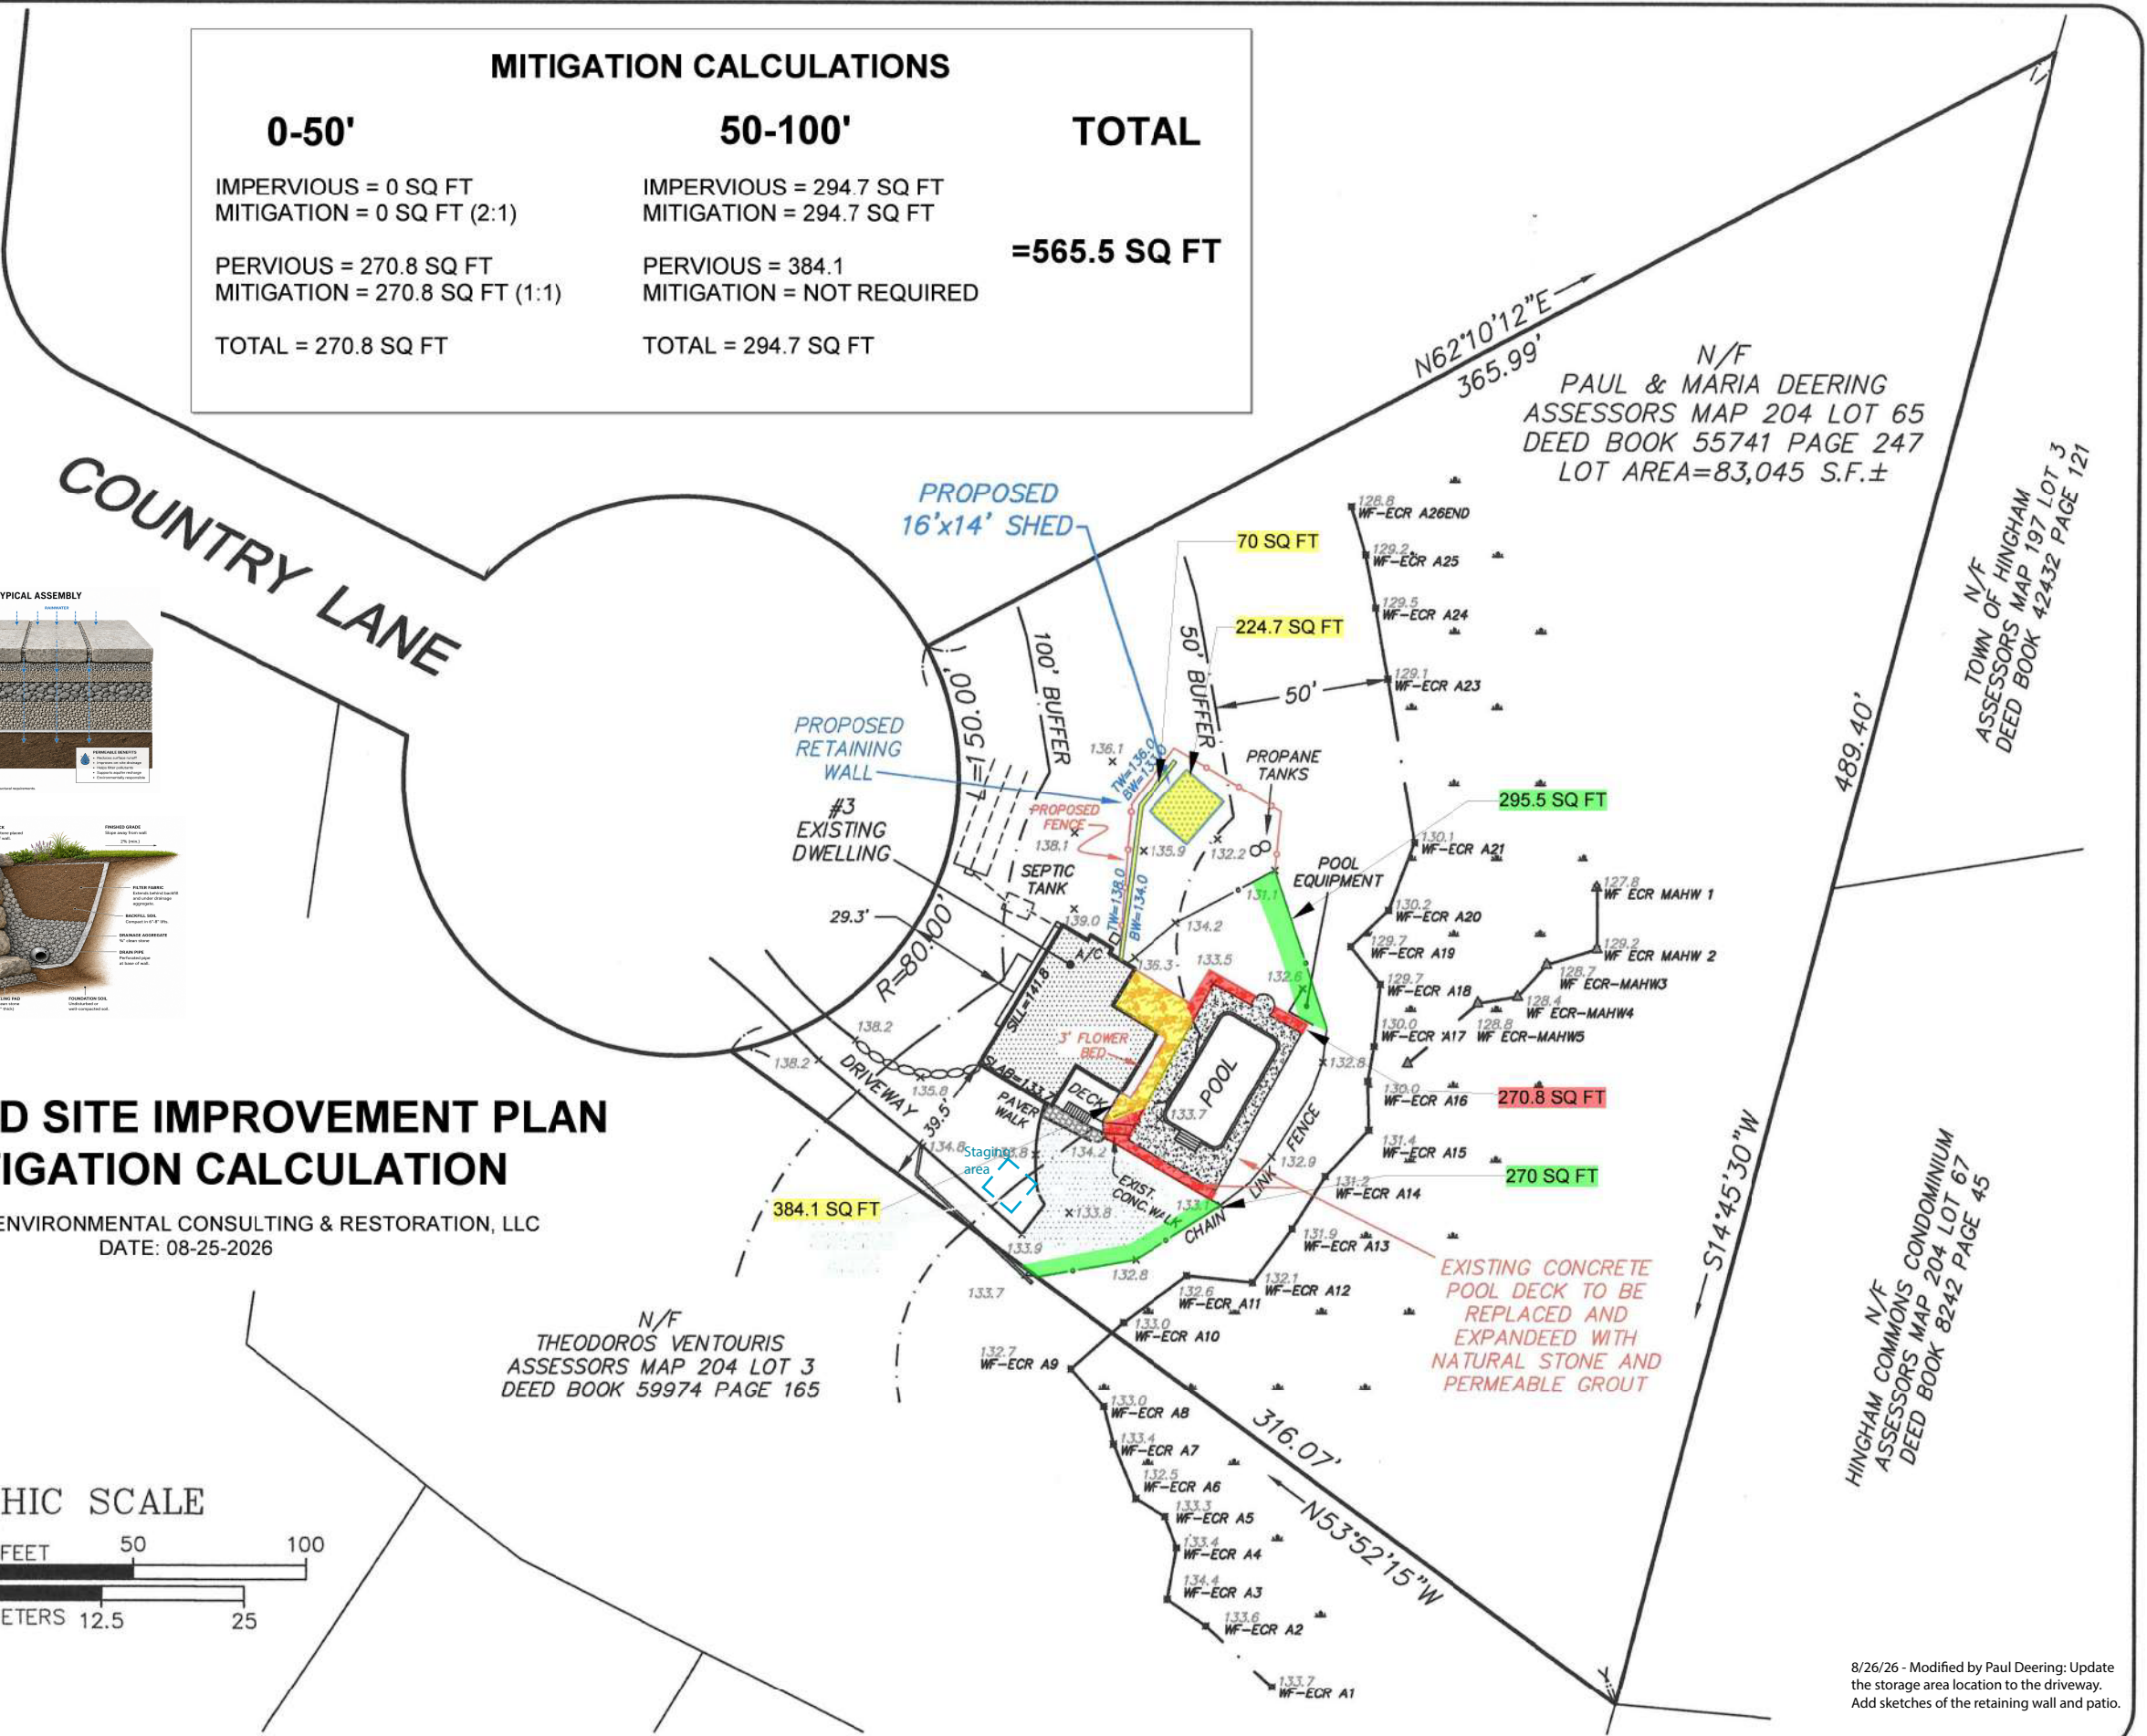

PROPOSED SITE IMPROVEMENT PLAN & MITIGATION CALCULATION

PREPARED BY: ENVIRONMENTAL CONSULTING & RESTORATION, LLC
DATE: 08-25-2026

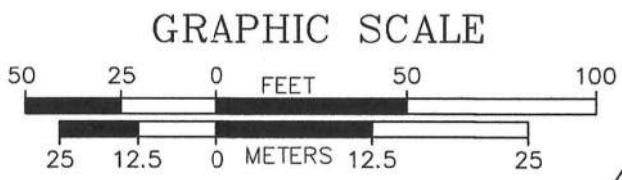

8/26/26 - Modified by Paul Deering: Update the storage area location to the driveway. Add sketches of the retaining wall and patio.

Sheet Title	S I T E P L A N O F L A N D	Project Name	3 COUNTRY LANE HINGHAM, MASSACHUSETTS PLYMOUTH COUNTY		Prepared for	PAUL DEERING	
		Scale	1"=50'	Date	AUGUST 25, 2026	Fig. No.	1
PERKINS ENGINEERING, INC.		1287 WASHINGTON STREET WEYMOUTH, MASSACHUSETTS 02189 TEL: 781-749-3600					