


N/F
MITCHEL & HEATHER SABATTIS
ASSESSORS MAP 108 LOT 39
DEED BOOK 40718 PAGE 291

WETLAND DELINEATION
BY KEN THOMSON, PWS
ON 4/23/2025

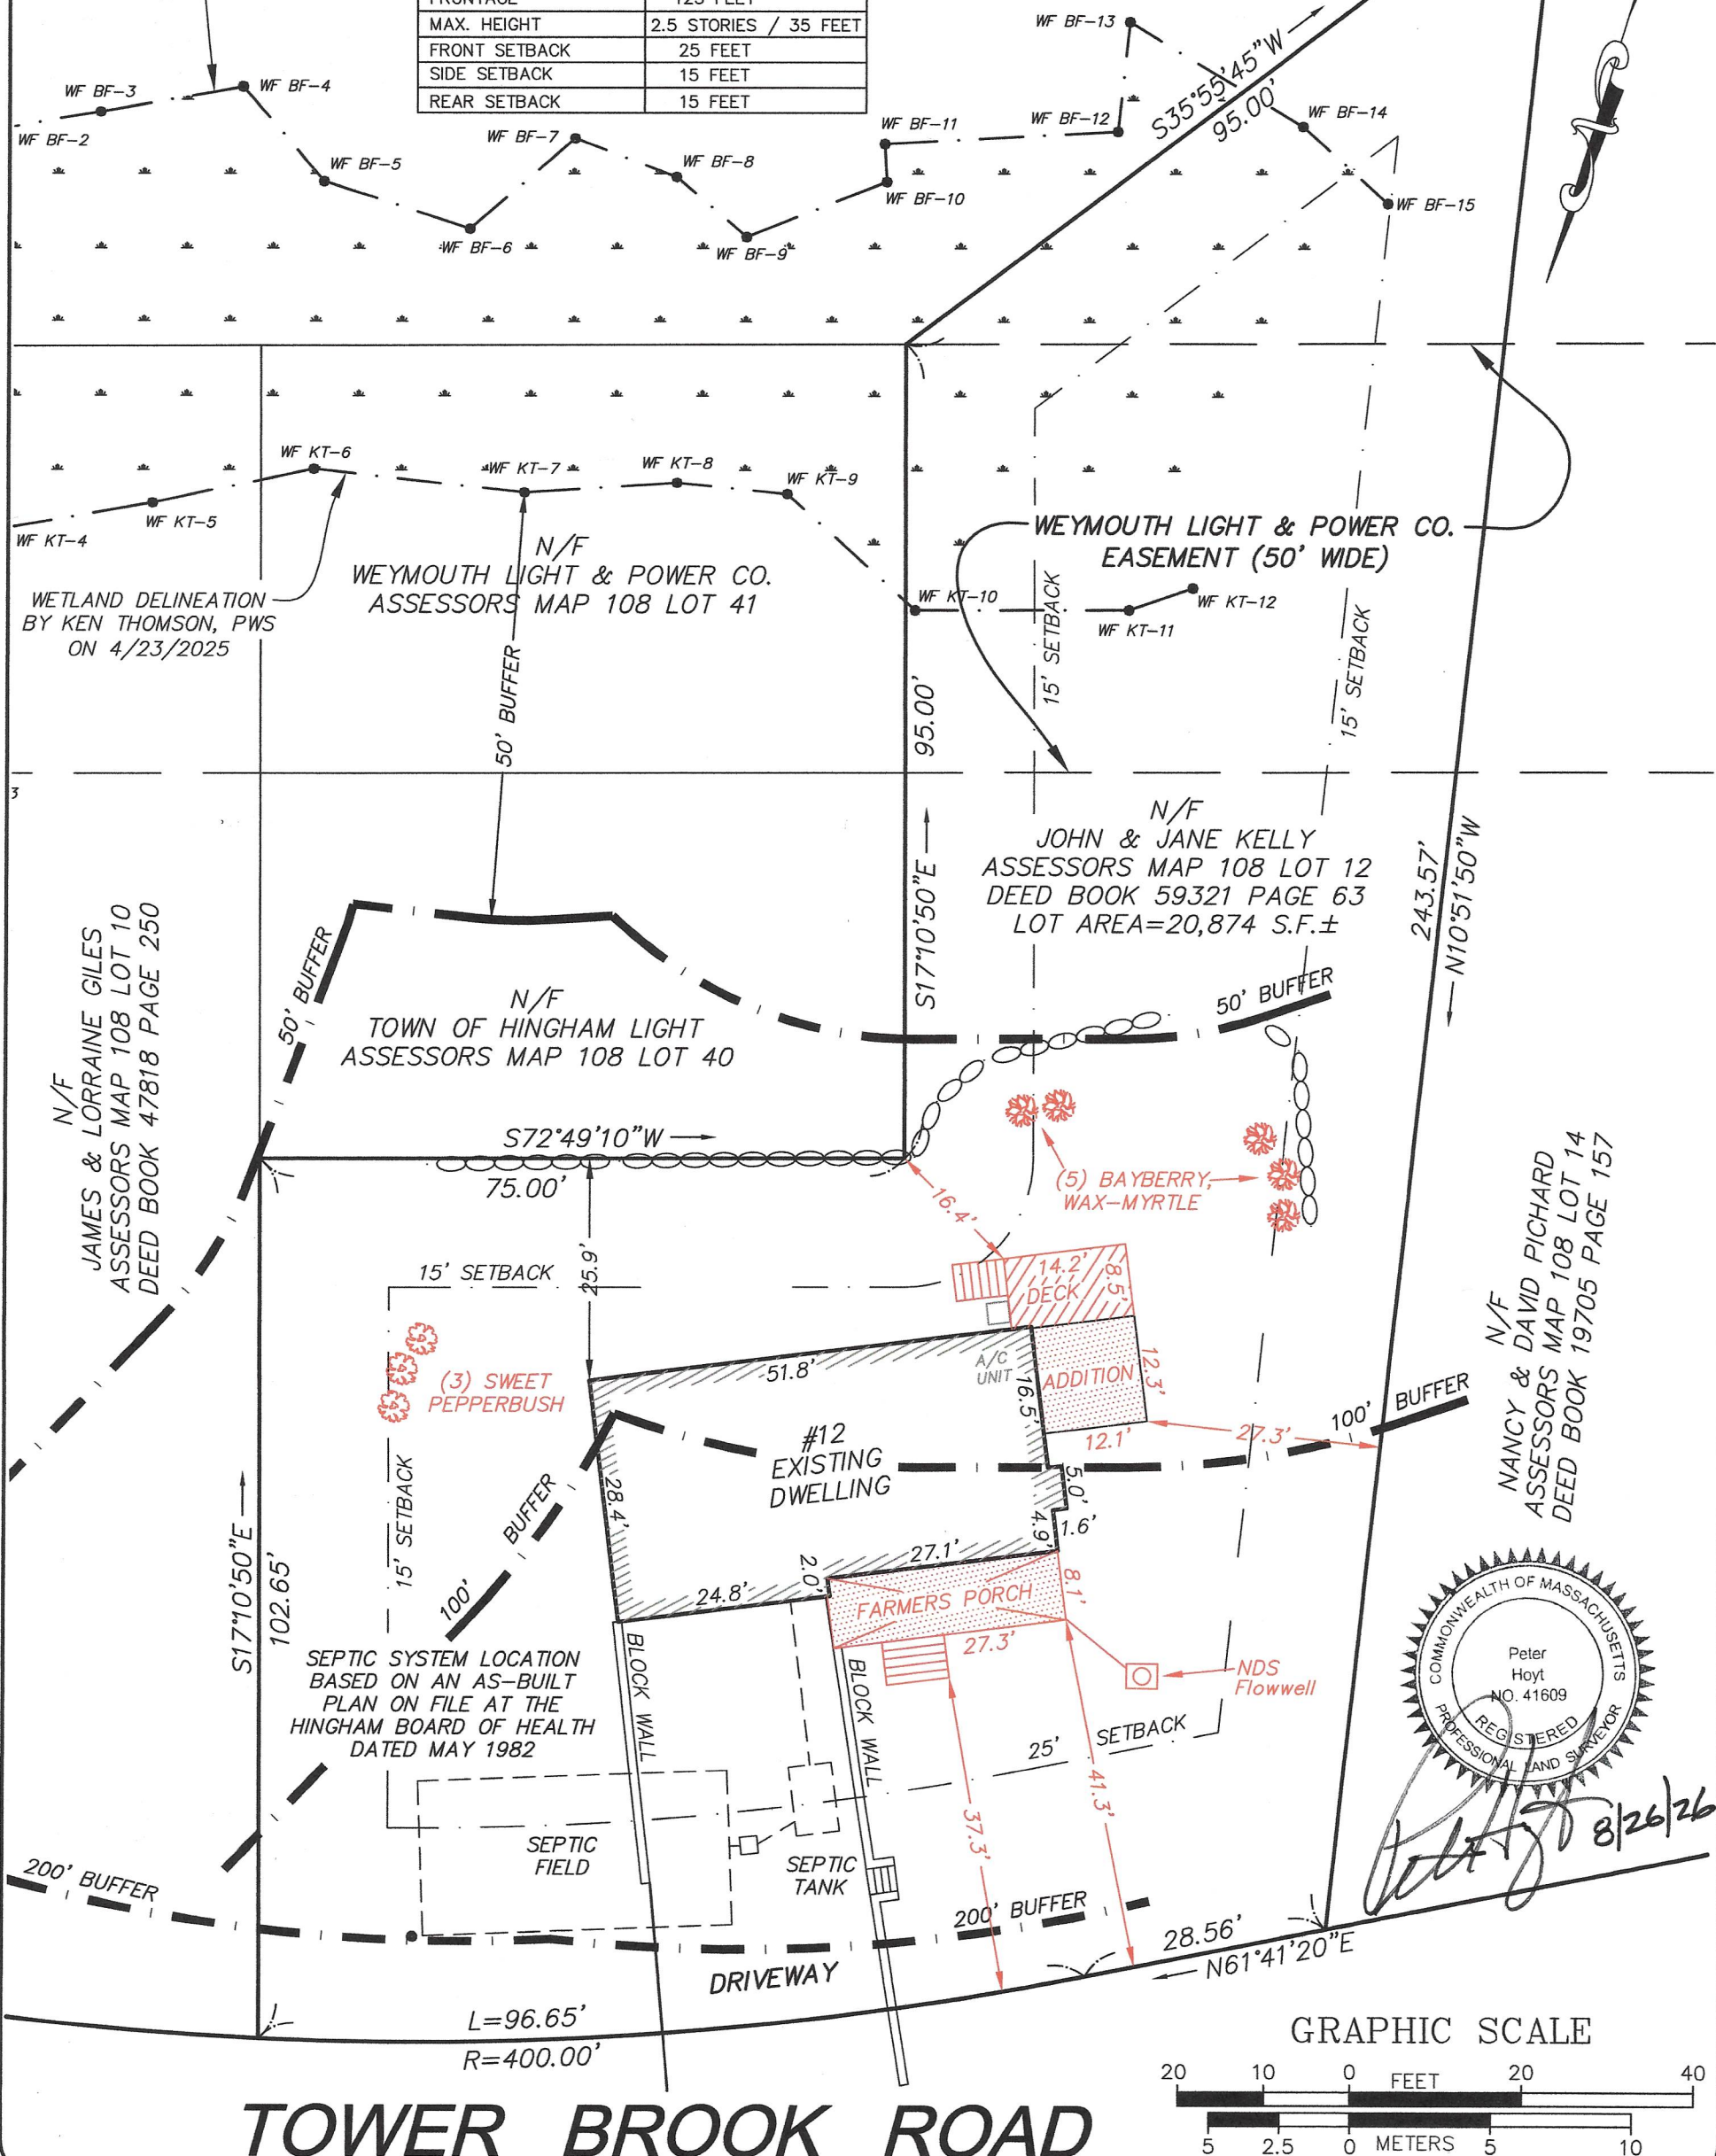

TOWER BROOK ROAD

Sheet Title

Project Name

12 TOWER BROOK ROAD
HINGHAM, MASSACHUSETTS
PLYMOUTH COUNTY

Prepared for

JACK KELLY



1287 WASHINGTON STREET
WEYMOUTH, MASSACHUSETTS 02189
TEL: 781-749-3600

Scale

 $1''=20'$

Date _____

AUGUST 26, 2026

File No.

Fig. No.

1